


GROUND FLOOR PLAN (TYPICAL)

SCALE: $1/4'' = 1'$

LEGEND

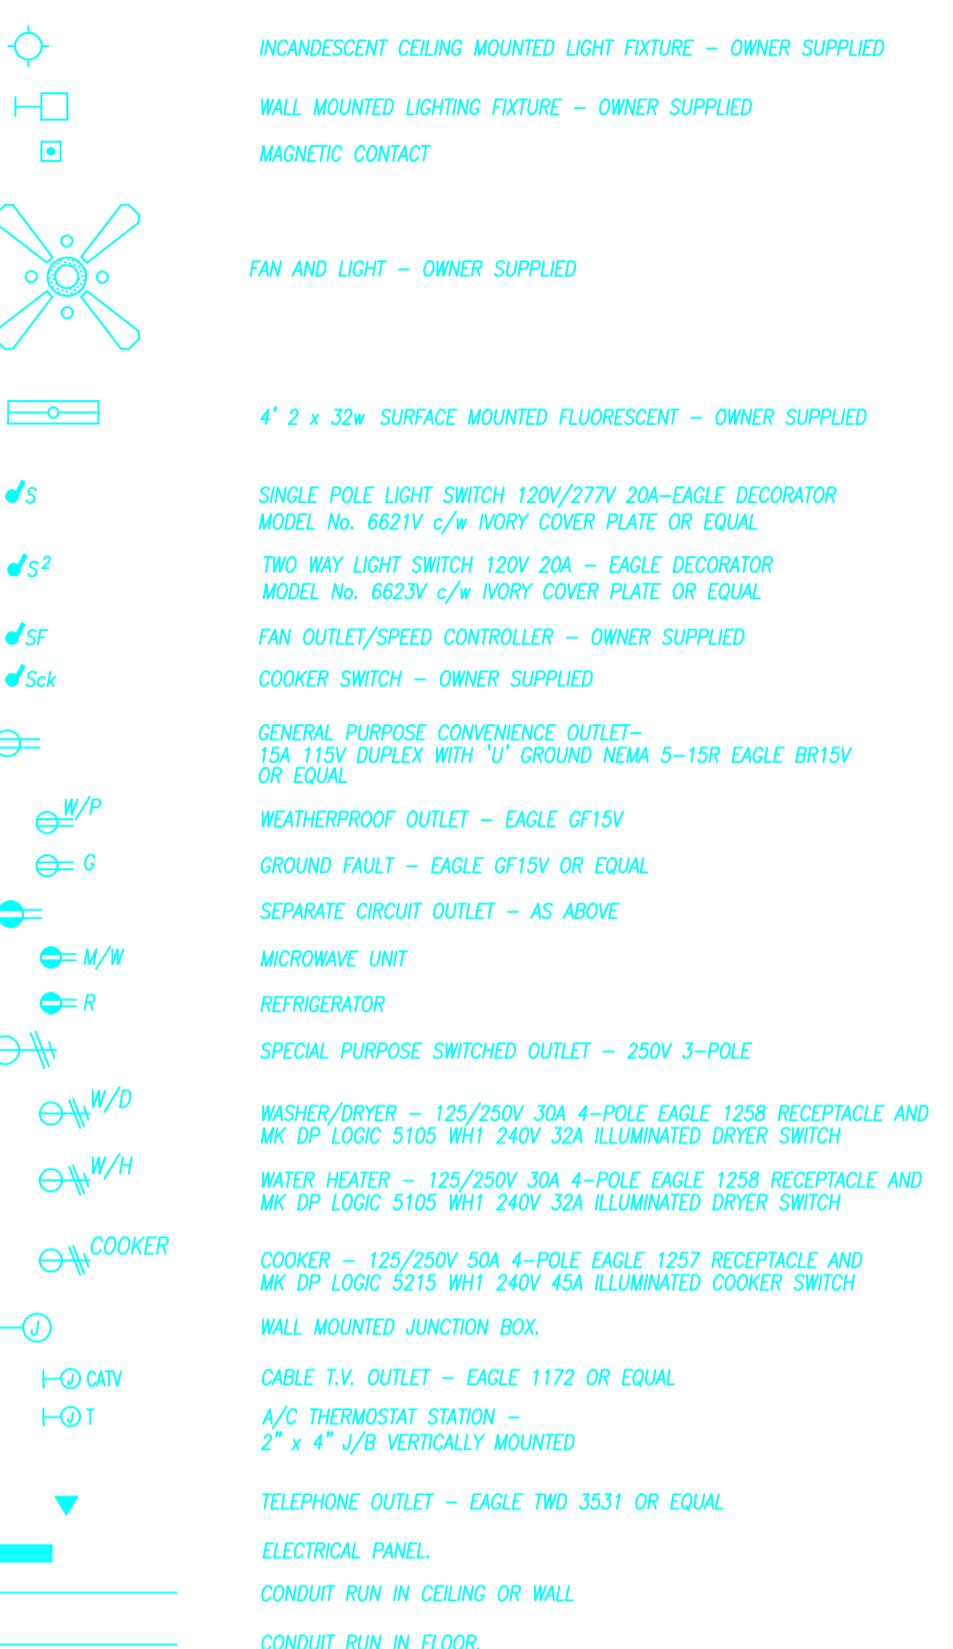

NOTES

- 1) ALL ELECTRICAL WORK SHALL BE DONE ACCORDING TO LOCAL CODES AND ORDINANCES.
- 2) ALL OUTLET LOCATIONS ARE MEASURED TO CENTER LINE OF BOX.
- 3) THE HEIGHT OF ALL OUTLETS TO BE 16" AFF UNLESS OTHERWISE NOTED.
- 4) SWITCH PLATES, OUTLET, COVERS TO BE WHITE UNLESS OTHERWISE NOTED. ALL OPEN BOXES TO HAVE BLANK PLATES.
- 5) ELECTRICAL CONTRACTOR SHALL LABEL ALL BREAKER PANELS AND MARK UP A SET OF ARCHITECTURAL PLANS INDICATING CIRCUITS AS INSTALLED.
- 6) PROVIDE OBM WITH A COPY OF THE APPROVED ELECTRICAL INSPECTION.
- 7) ALL WIRING SHALL BE CONCEALED UNLESS OTHERWISE NOTED.

FAN CONTROL WIRING SCHEMATIC

(NOTE: CEILING FANS & SPEED CONTROL SWITCHES TO BE OWNER SUPPLIED)

AS-BUILT DRAWING

Date! 22-01-10

	11.04.08	GENERAL REVISION	A.S.	
	19.03.08	GENERAL REVISION	A.S.	
SION	DATE	DESCRIPTION	BY	APP'D
	OBM Limited Architecture Resort Design & Development Town Planning Landscaping	PO Box 906 St. John's Antigua West Indies www.obmi.com E: obmanto@obmi.com T: 268 462 1047	Antigua Barbuda Barbuda British Virgin Islands Cayman Islands Molded Mexico	

CABLE BAY PROPERTY DEVELOPMENT

 ME: ablebay-grd-lig-pow	EDC CONSULTANTS LTD 42, Luis Street, Woodbrook, P.O.S., Trinidad, W.I. Tele: (868)628-8604 Fax:(868)622-7775		
	TRADE:	ELECTRICAL	
	DWG. TITLE:	BEACH FRONT APTS-GROUND FLOOR LIGHTING/POWER LAYOUT	
	EDC.C.L.	CHECKED:	PROJECT No.:
A.SHAH	SCALE: $1/4" = 1'$	05-030	
29/01/06	APP'D:	DWG. No.:	REVISION:
		E-06	2