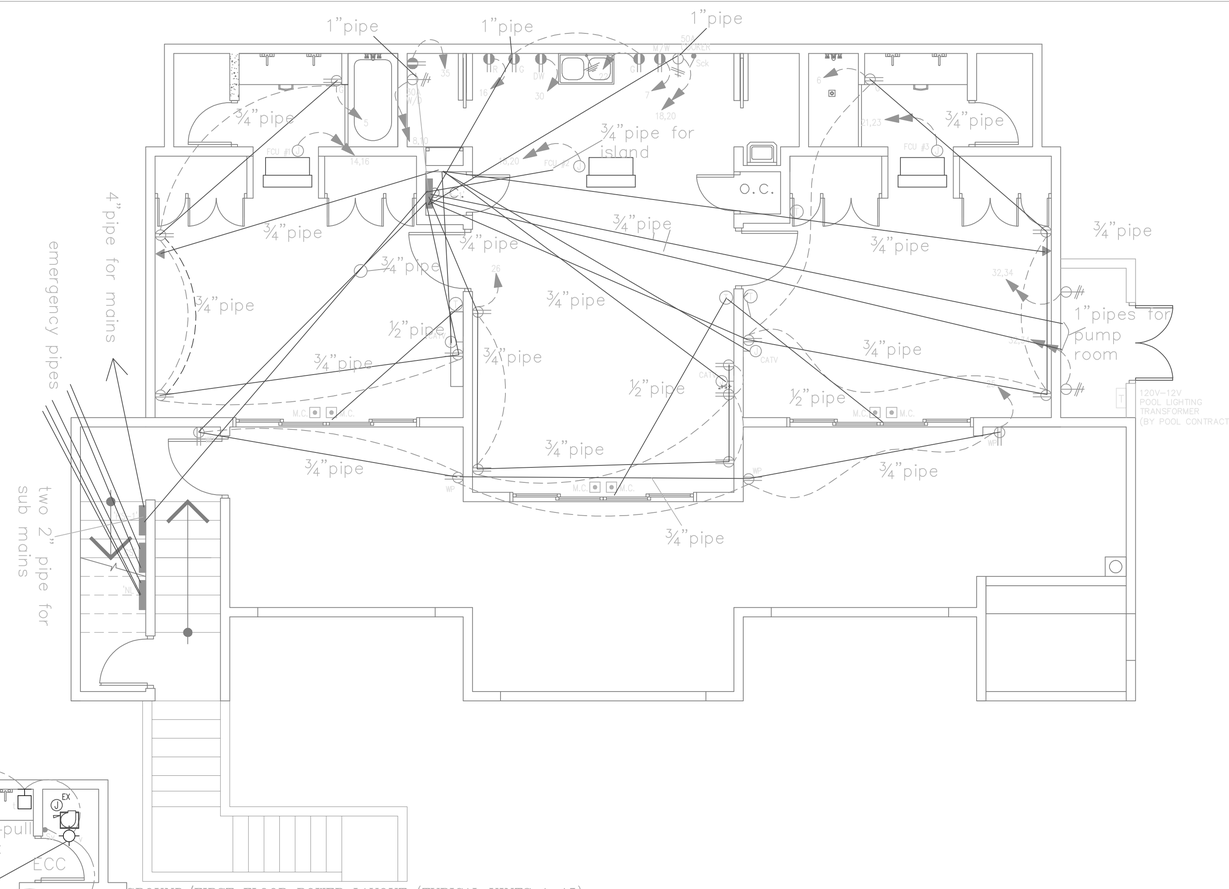

GROUND/FIRST FLOOR POWER LAYOUT (TYPICAL UINTS 1-15)

Scale : 1/4" = 1'

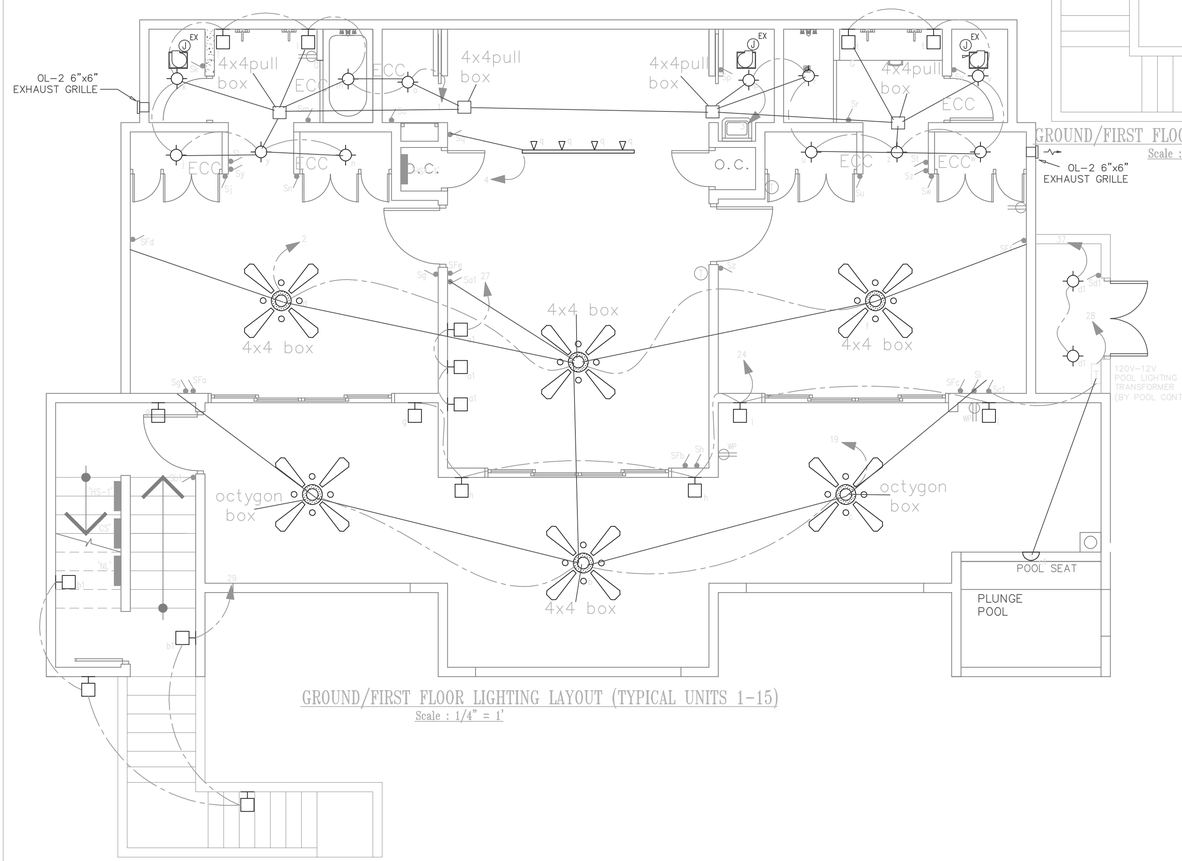

GROUND/FIRST FLOOR LIGHTING LAYOUT (TYPICAL UNITS 1-15)

Scale : 1/4" = 1'

ELEVATION - KITCHEN EQUIPMENT

Scale : 3/4" = 1'

LEGEND

- INCANDESCENT CEILING MOUNTED LIGHT FIXTURE - OWNER SUPPLIED
- WALL MOUNTED LIGHTING FIXTURE - OWNER SUPPLIED
- WALL MOUNTED LIGHTING FIXTURE - OWNER SUPPLIED
- THERMOSTAT
- MAGNETIC CONTACT
- FAN AND LIGHT - OWNER SUPPLIED
- S — SINGLE POLE LIGHT SWITCH 120V/277V 20A-EAGLE DECORATOR MODEL No. 6621V c/w IVORY COVER PLATE OR EQUAL
- S² — TWO WAY LIGHT SWITCH 120V 20A - EAGLE DECORATOR MODEL No. 6623V c/w IVORY COVER PLATE OR EQUAL
- SF — FAN OUTLET/SPEED CONTROLLER - OWNER SUPPLIED
- Sck — COOKER SWITCH - OWNER SUPPLIED
- GENERAL PURPOSE CONVENIENCE OUTLET- 15A 115V DUPLEX WITH 'U' GROUND NEMA 5-15R EAGLE BR15V OR EQUAL
- W/P — WEATHERPROOF OUTLET - EAGLE GF15V
- G — GROUND FAULT - EAGLE GF15V OR EQUAL
- SEPARATE CIRCUIT OUTLET - AS ABOVE
- M/W — MICROWAVE UNIT
- DW — DISHWASHER
- R — REFRIGERATOR
- SPECIAL PURPOSE SWITCHED OUTLET - 250V 3-POLE
- W/D — WASHER/DRYER - 125/250V 30A 4-POLE EAGLE 1258 RECEPTACLE AND MK DP LOGIC 5105 WH1 240V 32A ILLUMINATED DRYER SWITCH
- COOKER — COOKER - 125/250V 50A 4-POLE EAGLE 1257 RECEPTACLE AND MK DP LOGIC 5215 WH1 240V 45A ILLUMINATED COOKER SWITCH
- J — WALL MOUNTED JUNCTION BOX.
- CATV — CABLE T.V. OUTLET - EAGLE 1172 OR EQUAL
- T — A/C THERMOSTAT STATION - 2" x 4" J/B VERTICALLY MOUNTED
- TELEPHONE OUTLET - EAGLE TWO 3531 OR EQUAL
- ELECTRICAL PANEL.
- CONDUIT RUN IN CEILING OR WALL
- CONDUIT RUN IN FLOOR.

AS-BUILT DRAWING

Date! 22-01-10

NOTES

1) ALL ELECTRICAL WORK SHALL BE DONE ACCORDING TO LOCAL CODES AND ORDINANCES.
2) ALL OUTLET LOCATIONS ARE MEASURED TO CENTER LINE OF BOX.
3) THE HEIGHT OF ALL OUTLETS TO BE 16" AFF UNLESS OTHERWISE NOTED.
4) SWITCH PLATES, OUTLET, COVERS TO BE WHITE UNLESS OTHERWISE NOTED. ALL OPEN BOXES TO HAVE BLANK PLATES.
5) ELECTRICAL CONTRACTOR SHALL LABEL ALL BREAKER PANELS AND MARK UP A SET OF ARCHITECTURAL PLANS INDICATING CIRCUITS AS INSTALLED.
6) PROVIDE OBM WITH A COPY OF THE APPROVED ELECTRICAL INSPECTION.
7) ALL WIRING SHALL BE CONCEALED UNLESS OTHERWISE NOTED.
8) CABLE SIZES

LIGHTING.....1.5mm²
CONV./OLS.....2.5mm²
WASHER/DRYER.....4.0mm²
COOKER.....10mm²
PUMP.....1.5mm²
SOLAR WATER HEATER.....2.5mm²
A/C CONDENSING UNITS.....4.0mm²
FAN COIL UNITS.....1.5mm²

REVISION	DATE	DESCRIPTION	BY	APP'D
3	17.SEP.08	STAIR LIGHTS ADDED	A.S.	
2	01.OCT.07	FAN COIL UNITS ADDED	A.S.	
1	08.AUG.07	PUMP ROOM RELOCATED	A.S.	

OBM
OBM Limited
Architecture
Resort Design &
Development
Town Planning
Interior Design
PO Box 906
St. Johns
Antigua
West Indies
www.obml.com
E obmaxw@obml.com
T 268 462 1047
F 268 462 2305
Antigua
Bath, UK
Bermuda
British Virgin Islands
Cayman Islands
Idaho
Miami
Turks & Caicos Islands

CABLE BAY PROPERTY DEVELOPMENT

edc
EDC CONSULTANTS LTD
42, Luis Street, Woodbrook, P.O.S., Trinidad, W. Tele: (868)628-8604 Fax:(868)622-7775

FILE NAME: cablebay-grd-llg-pow

TRADE: ELECTRICAL

DWG. TITLE: UPPER HILLSIDE - GROUND FLOOR LIGHTING / POWER LAYOUT AND KITCHEN EQUIPMENT LAYOUT

DESIGNED:	CHECKED:	PROJECT No.:
EDC.C.L.		05-030
DRAWN: A.SHAH	SCALE: 1/4" = 1'	DWG. No.: E-17U / REVISION: 3
DATE: 20/01/06	APP'D:	

© DRAWING COPYRIGHT NOTICE:
THESE DRAWINGS ARE INSTRUMENTS OF SERVICE AND SHALL REMAIN THE PROPERTY OF EDC CONSULTANTS LIMITED. WHETHER THE PROJECT FOR WHICH THEY ARE PREPARED IS EXECUTED OR NOT. THESE DRAWINGS SHALL NOT BE USED IN PART OR IN WHOLE FOR ANY OTHER PROJECT OR AS AN EXTENSION TO THIS PROJECT WITHOUT WRITTEN AUTHORIZATION BY AND APPROPRIATE COMPENSATION TO EDC CONSULTANTS LIMITED.

REVISION	DATE	DESCRIPTION	BY	APP'D